



MANTICLA SAL NATIONAL FOREST VEGETATION COVER TYPE MAPPING

- GRASSLANDS**
- 10 GRASSLANDS UNCLASSIFIED
  - 11 PERENNIAL GRASSLANDS (HIGH ELEVATIONS)
  - 12 PERENNIAL GRASSLANDS (MID-LOW ELEVATIONS)
  - 13 DESERT GRASSLANDS

- RIPARIAN LANDS**
- 20 PERENNIAL WET LANDS & MEADOWS
  - 21 TREE DOMINATED RIPARIAN AREAS
  - 22 INTERMITTENT WET/DRY MEADOWS
  - 23 WILLOW DOMINATED RIPARIAN AREAS
  - 24 OTHER SHRUB DOMINATED RIPARIAN AREAS
  - 25 LAKES, PONDS & RESERVOIRS

- PERENNIAL FORBLANDS**
- 30 PERENNIAL FORB LANDS (HIGH & MID ELEVATIONS)
  - 31 PERENNIAL FORB LANDS (ALPINE & SUB-ALPINE ELEVATIONS)
  - 32 PERENNIAL FORB LANDS (MID TO LOW ELEVATIONS)
  - 33 ACTIVE LAND SLIDES-WITH LITTLE OR NO VEGETATION COVER

- SAGEBRUSHLANDS**
- 40 BLACK SAGEBRUSH
  - 41 WYOMING BIG SAGEBRUSH
  - 42 BASIN BIG SAGEBRUSH
  - 43 BIG MOUNTAIN SAGEBRUSH
  - 44 SILVER SAGEBRUSH
  - 45 RABBIT BRUSH (RUBBER & YELLOW BRUSH)

- MOUNTAIN BRUSH LANDS**
- 50 MOUNTAIN BRUSH
  - 51 OAKBRUSH
  - 52 MOUNTAIN MAPLE
  - 53 CURLEAF MOUNTAIN MAHOGANY
  - 54 TRUE MOUNTAIN MAHOGANY
  - 55 HIGH MOUNTAIN BRUSH
  - 56 MANZANITA

- CONIFEROUS FOREST LANDS**
- 60 WHITE FIR FOREST
  - 61 PONDEROSA PINE FOREST
  - 62 DOUGLAS FIR FOREST
  - 63 SPRUCE-ALPINE-FIR FOREST
  - 64 BLUE SPRUCE FOREST
  - 65 LIMBER PINE & BRISTLE CONE FOREST

- ASPEN FOREST LANDS**
- 80 ASPEN FOREST LANDS
  - 81 ASPEN SNOWBERRY
  - 82 ASPEN BIG SAGEBRUSH
  - 83 ASPEN CREEPING BARBERRY
  - 84 ASPEN MIXED MOUNTAIN BRUSH
  - 85 ASPEN MIXED CONIFER

- PINYON JUNIPER WOODLANDS**
- 90 PINYON JUNIPER WOODLANDS
  - 91 UTAH JUNIPER WOODLANDS
  - 92 PINYON WOODLANDS
  - 93 ROCKY MOUNTAIN JUNIPER WOODLANDS
  - 99 BARREN ROCK OUTCROPS & LEDGES


- LEGEND**
- MILL FORK LEASE PROPERTY BOUNDARY
  - COAL LEASE BOUNDARY
  - DEER CREEK MINE PERMIT BOUNDARY
  - EM-169 DRILL HOLE
  - AS-BUILT DISTURBED AREA BOUNDARY

DATA CONTENT AND USE DISCLAIMER: The USDA Forest Service, Monticla Sal National Forest, manages much of the data as a service to users of digital geographic data. The USFS is in no way condoning or endorsing the application of these data for any given purpose. It is the sole responsibility of the user to determine whether or not the data are suitable for the intended purpose. It is also the obligation of the user to apply those data in an appropriate and conscientious manner. The USFS provides no warranty, nor accepts any liability occurring from any incorrect, incomplete, or misleading use of these data. Much of the USFS data are based on and maintained with ARC/INFO software developed by Environmental Systems Research Institute (ESRI). Much of the information presented uses conventions and terms popularized by ARC/INFO and its user community. USFS in no way represents the interests of ESRI nor acts as an agent for them.

Vegetation information recreated with the use of USFS GIS Mapping

CAD FILE NAME/DISK#: 300-1 AS-BUILT

300-1

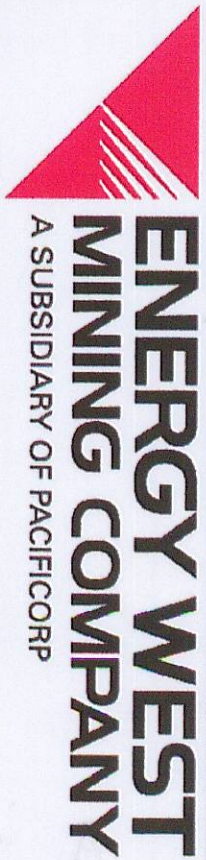

DEER CREEK MINE  
NORTH RILDA RIDGE  
VEGETATION MAP

File in: ☒ Confidential ☐ Expandable  
In C:\98018\Mining  
Date: 11/14/2010 For additional information

DATE	REVISION	BY	CHK
2/4/2010	ADDED AS-BUILT DISTURBED AREA BOUNDARY	K.L.	

RECEIVED

NOV 0 4 2010

DIV. OF OIL, GAS & MINING

DRAWN BY: K. LARSEN	DRAWING #: 300-1
SCALE: 1" = 1000'	SHEET 1 OF 1
DATE: MARCH 25, 2009	REV. 1